
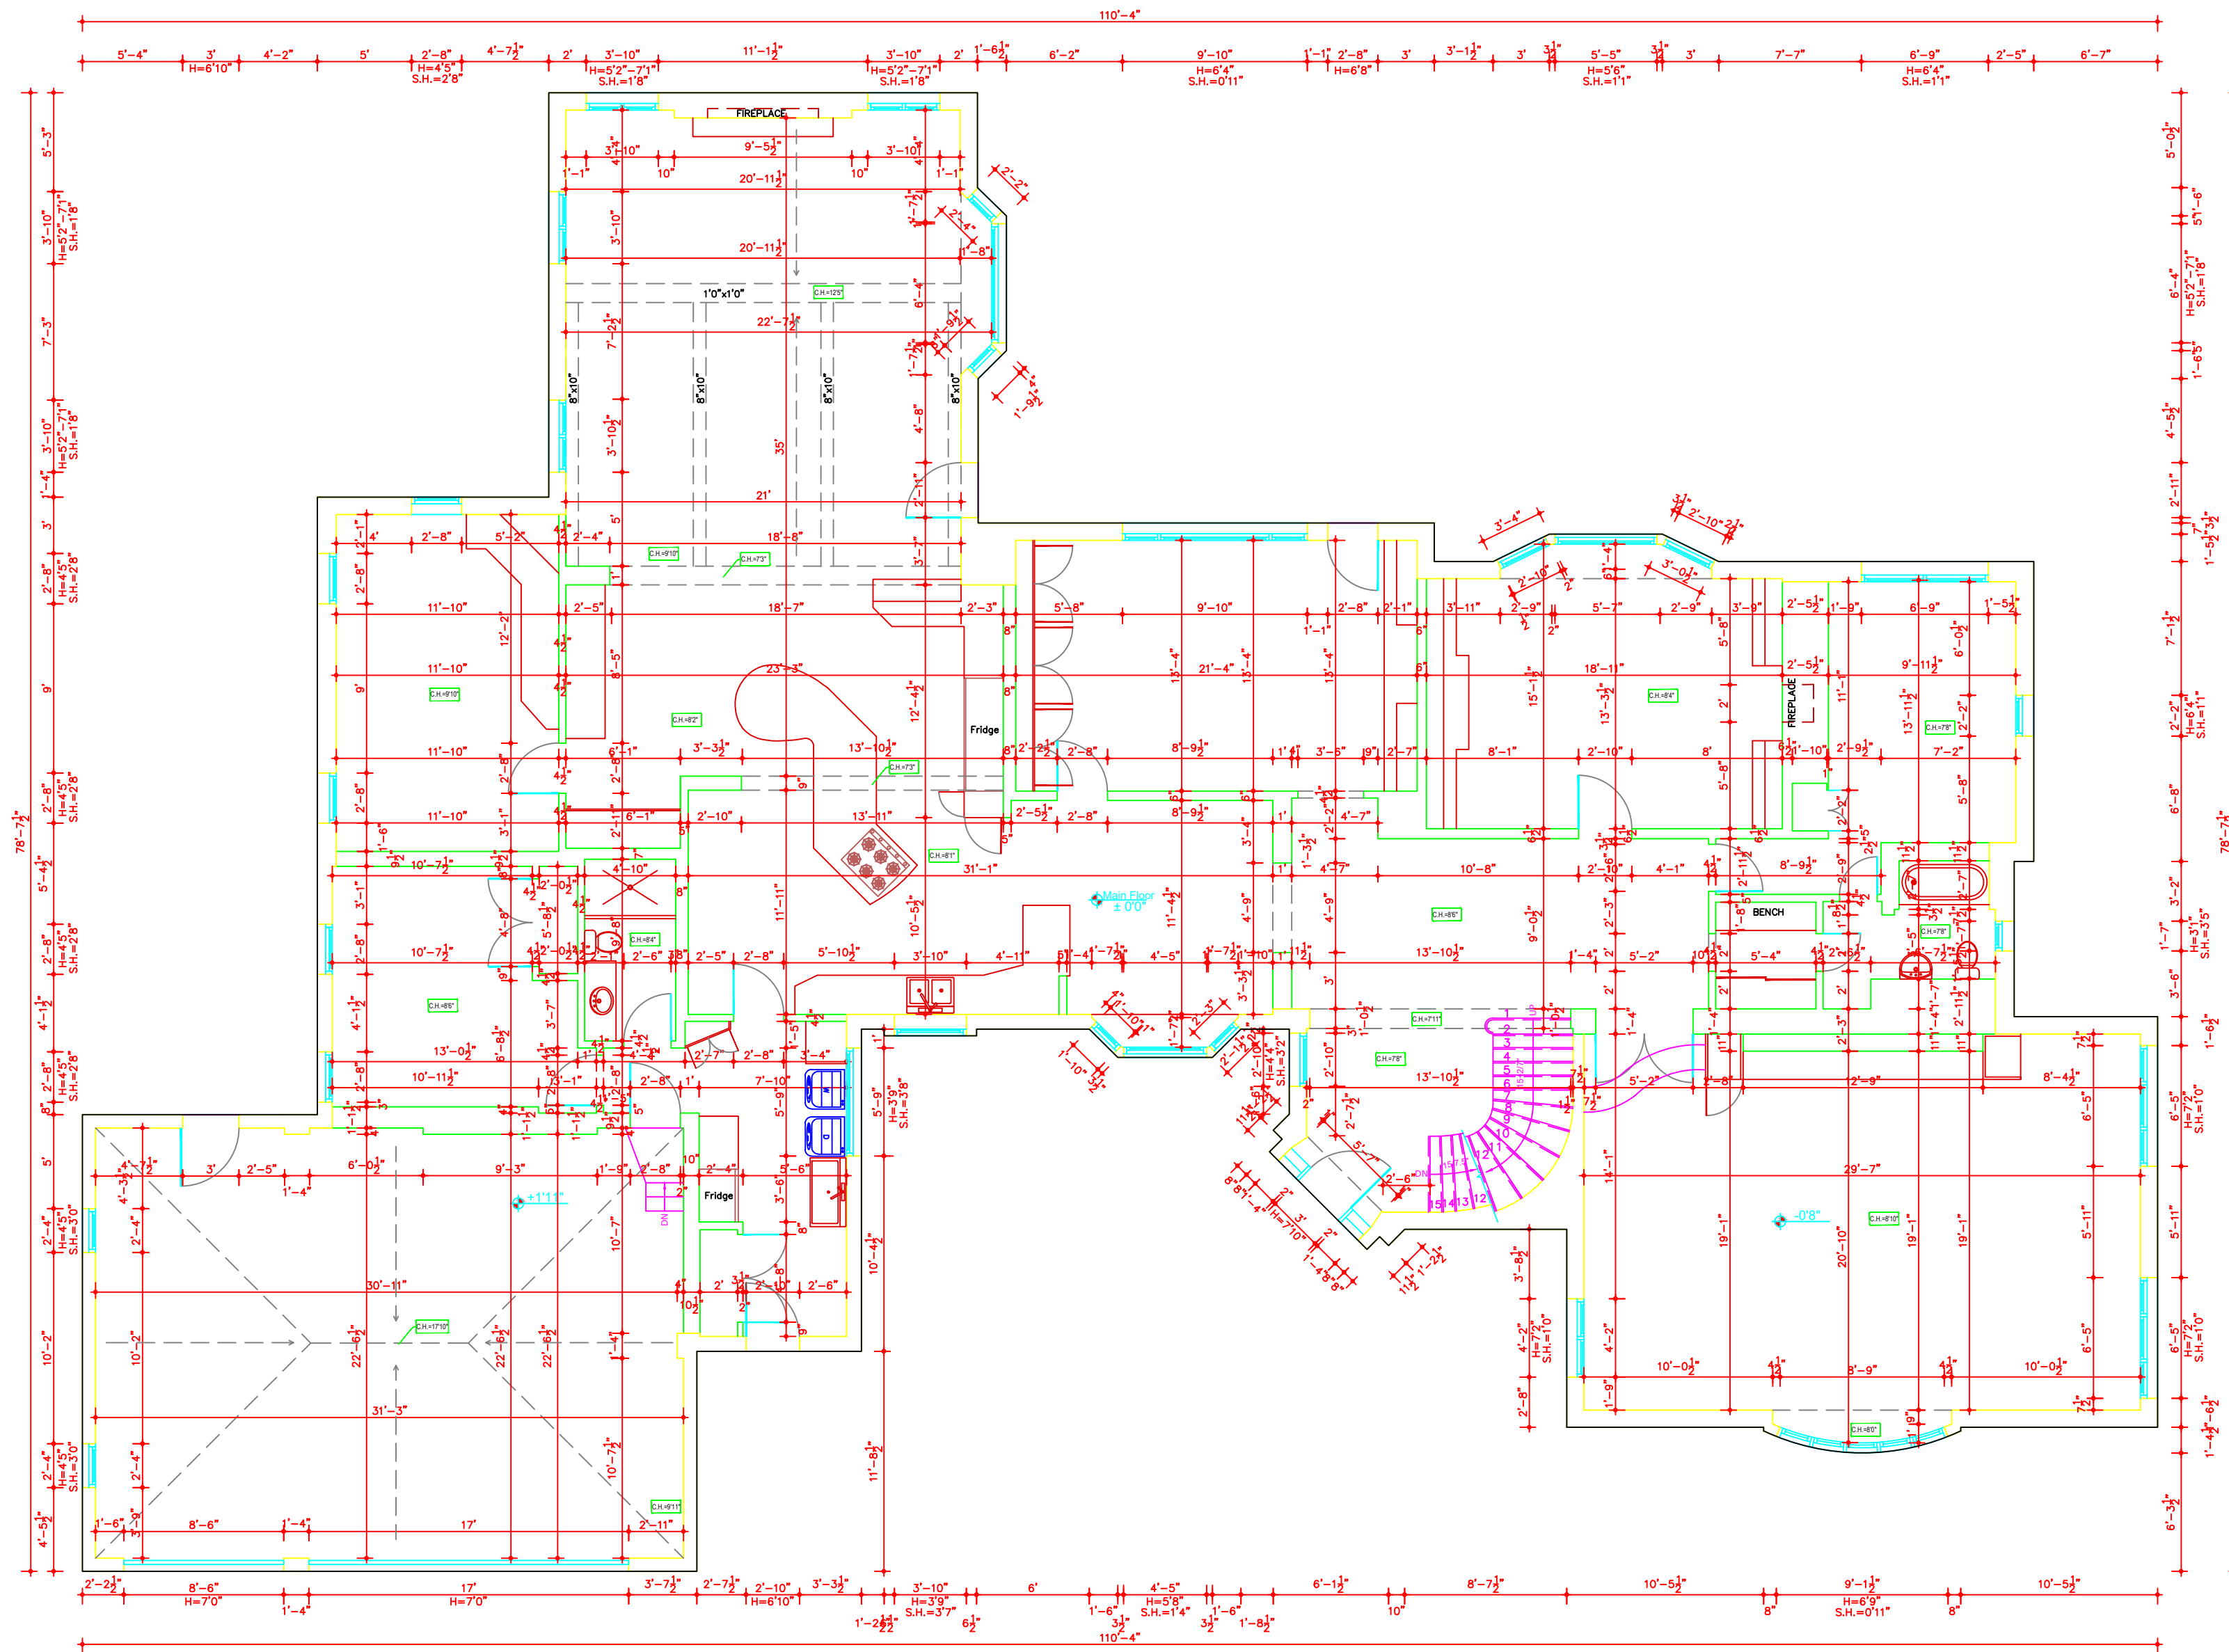


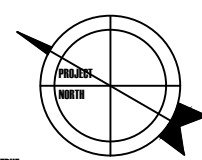

TITLE MAIN FLOOR AS-BUILT PLAN	SHT. 02	OF 06	PROJECT NO. 02-310	112 McNeilly Rd, Hamilton, ON L8E 5J1	NOTES: For preliminary planning purposes. All information must be checked and site verified	ORIENTATION 	ARCH-MEASURES ARCHITECTURAL MEASUREMENT SERVICES TEL: 647-546-6121 www.arch-measures.com info@arch-measures.com 3737 Major Mckenzie Dr W, #1266, Woodbridge ON, L4H 0A2	C:\Users\lucy\OneDrive\Arch\G2\Logo 2.JPG
	SCALE N.T.S.	DRAWN BY E.K.	DATE JAN/10/2024					